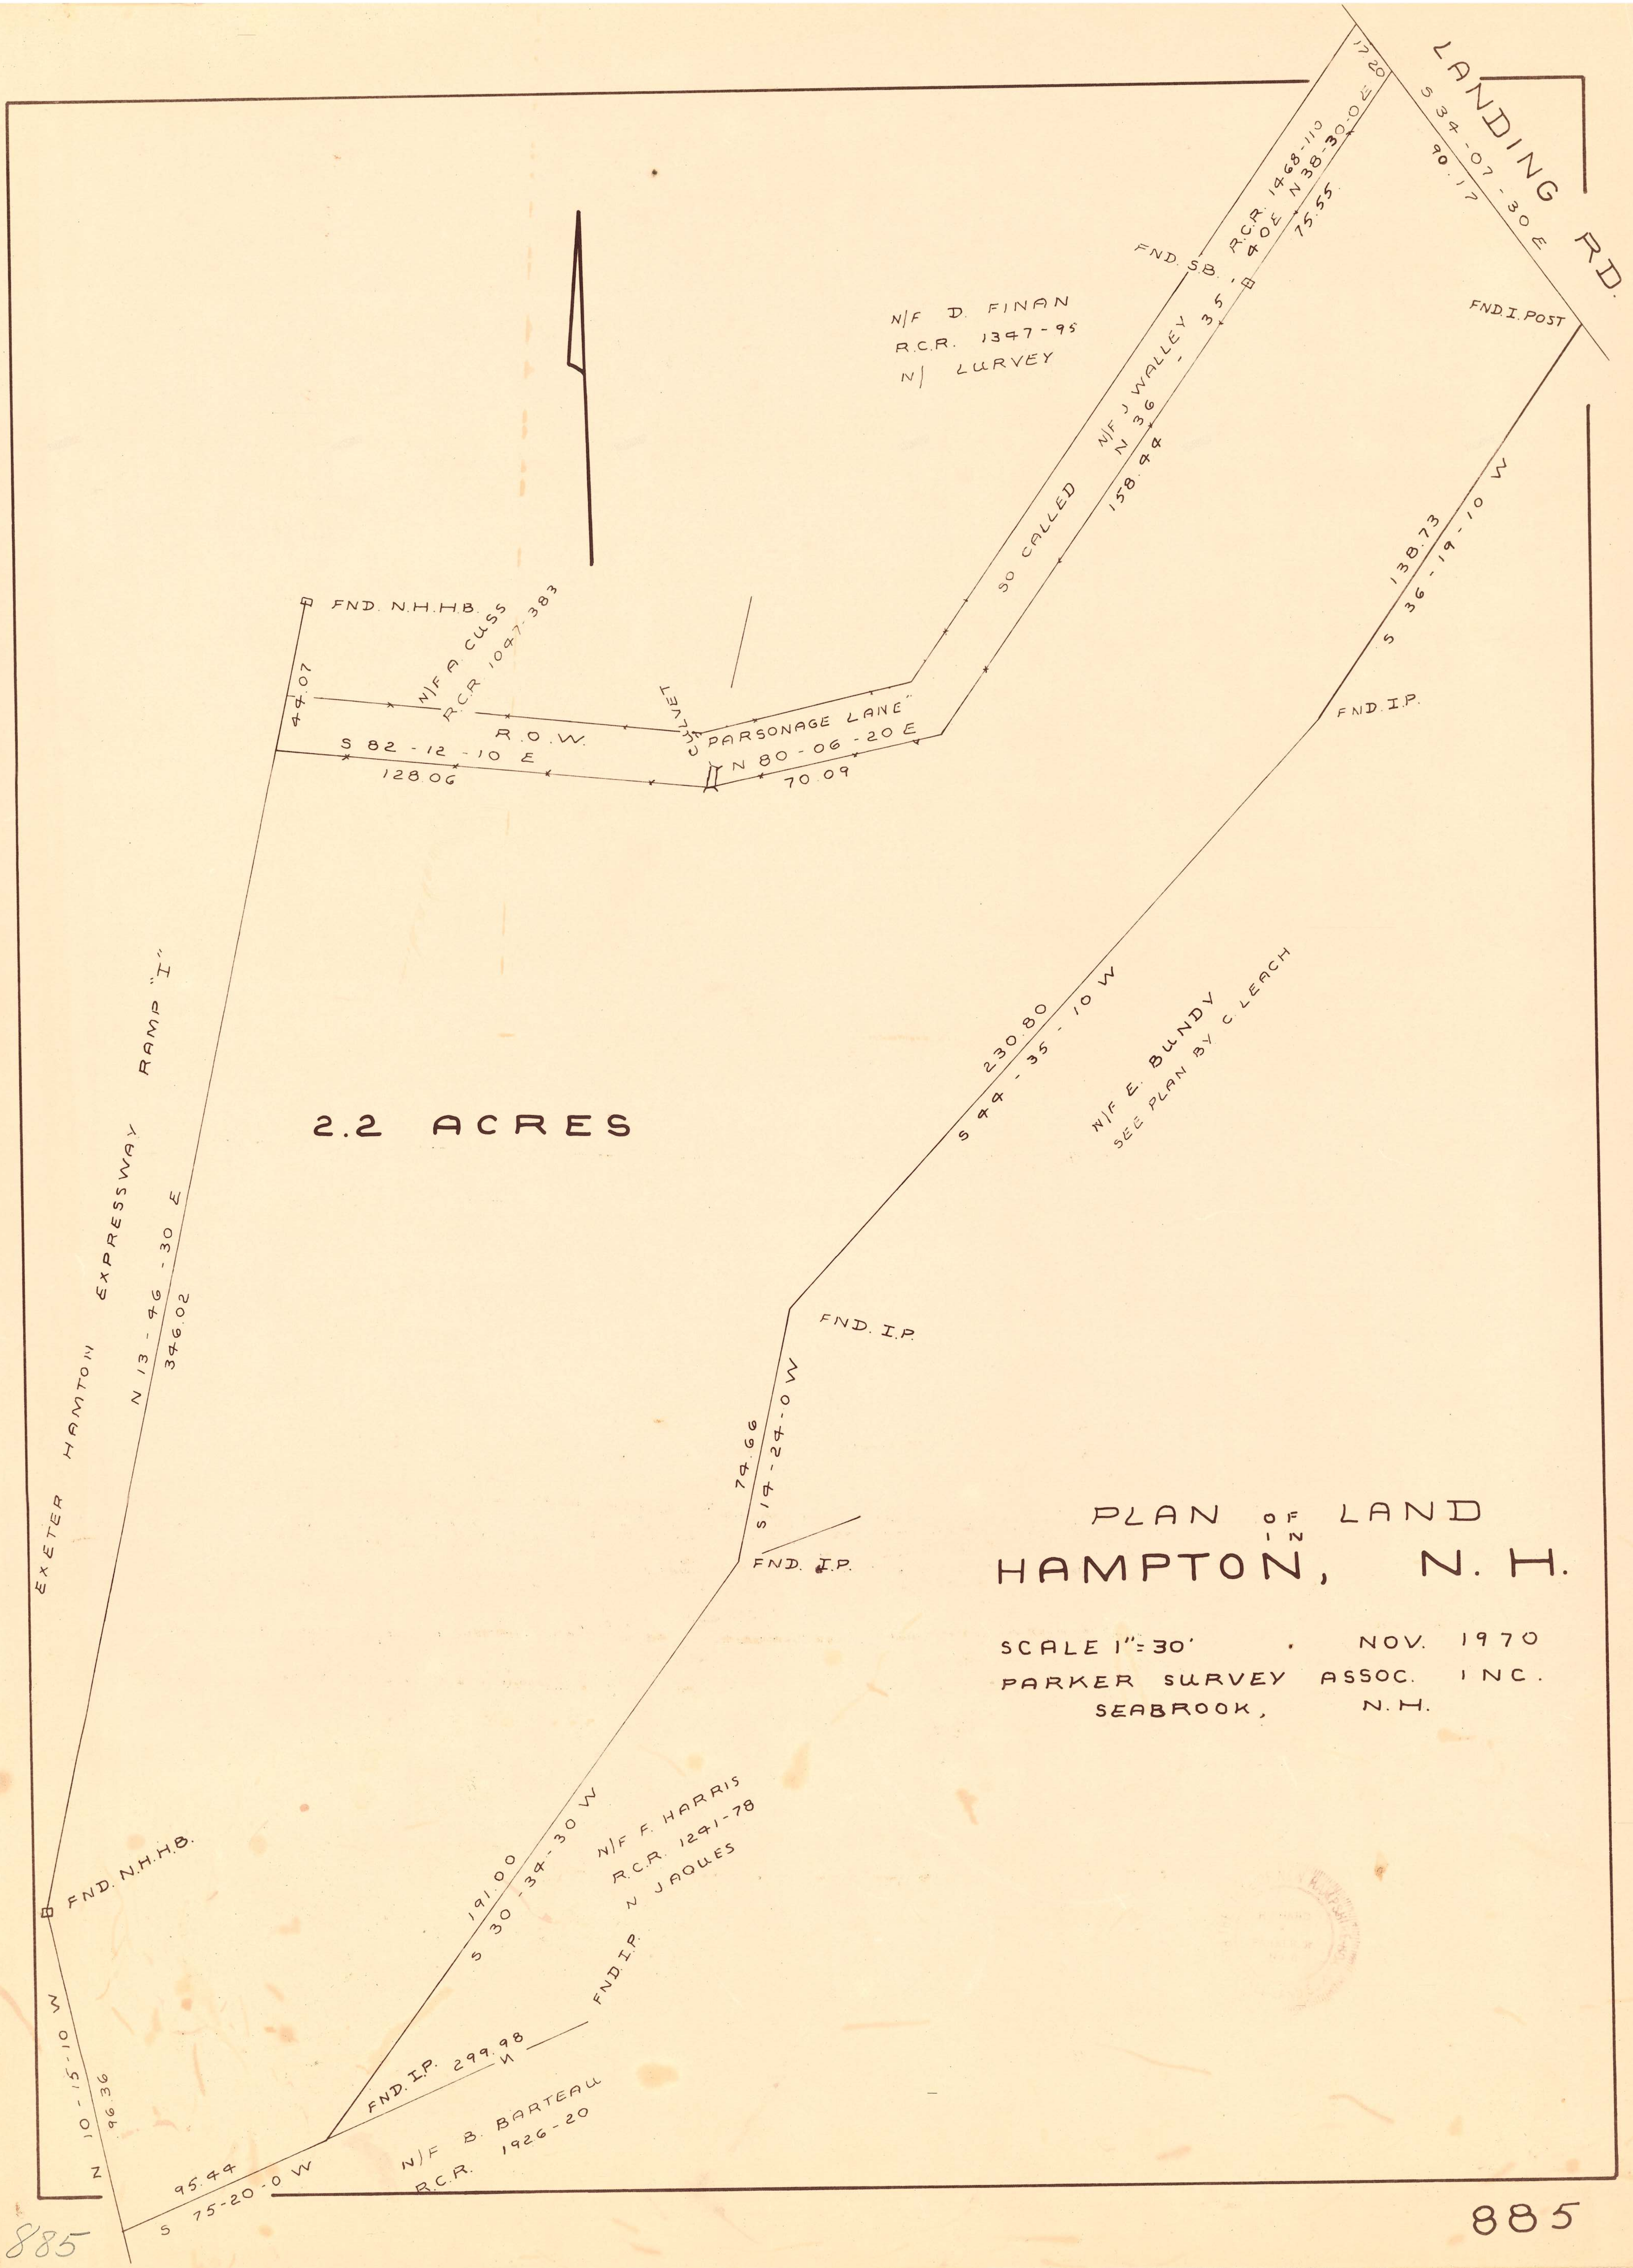
LANDING RD.
S 34-07-30 E
90.17
17.20
FND. S.B.
R.C.R. 1468-110
N 38-30-0 E
75.55
N/F J WALLEY
N 36-35-40 E
158.44
SO CALLED
FND. I. POST
N/F D. FINAN
R.C.R. 1347-95
N/ LURVEY
FND. N.H.H.B.
N/F A CUSS
R.C.R. 1047-383
44.07
R.O.W.
S 82-12-10 E
128.06
CULVET
"PARSONAGE LANE"
N 80-06-20 E
70.09
138.73
S 36-19-10 W
FND. I.P.
230.80
S 44-35-10 W
N/F E. BUNDY
SEE PLAN BY C. LEACH
2.2 ACRES
EXETER HAMTON EXPRESSWAY RAMP "I"
N 13-46-30 E
346.02
FND. I.P.
74.66
S 14-24-0 W
FND. I.P.
FND. N.H.H.B.
191.00
S 30-34-30 W
N/F F. HARRIS
R.C.R. 1241-78
N JAQUES
FND. I.P.
FND. I.P. 299.98
N
N 10-15-10 W
96.36
95.44
S 75-20-0 W
N/F B. BARTEAU
R.C.R. 1926-20

PLAN OF LAND IN HAMPTON, N.H.

SCALE 1" = 30' . NOV. 1970
PARKER SURVEY ASSOC. INC.
SEABROOK, N.H.

885

885


LANDING RD
2.2 AC
95-192 SF
N 64-17-59 E
5045.41
4714.41
5002.42
4703.87
50.79
44.27
5023.39
4668.64
S 82-12-06 E
128.06
CULVET
4983.04
4830.33
N80-06-23E
70.09
#1F TACK SET FNC IN TREE
S 88-37-55 W
96.75
COR 4997.69
4903.28
4997.08
4899.83
1583.44
N 36-35-40
228.99
N 80-58-45 W
98.85
N 38-30-05
58-50-15
#1A' FND I. FNC POST
5181.54
5039.79
COR 5183.42
5041.34
COR 5184.95
5039.29
#1A FND I.P.
5102.79
5091.88
S 31-59-25 E
190.19
#1A² FND I.P.
4999.36
5134.30
#1A³ Set TACK
4947.48
5192.44
S 11-49-25 W
262.03
#1A⁴ Set TACK
4691.01
5138.95
S 80-40-03 W
118.33
#1A⁵ FND I.P.
4671.82
5022.18
#1 Set HUB
5000.00
5000.00
#1B FND I.P.
4999.01
5009.71
S 78-54-35 E
138.73
S 36-19-11 W
N 59-55-23 E
247.71
S 50-11-00 W
189.28
S 44-35-15 W
230.80
#2 Set HUB
4878.80
4854.61
#2A FND I.P.
4832.64
4847.69
S 14-24-04 W
79.66
#3A FND I.P.
4760.32
4829.12
#3 Set HUB
4726.05
4809.65
S 30-34-22 W
191.88
S 30-47-23 W
#7 Set HUB
4875.82
4785.55
138.66
70-44-32 W
N 22-29-0 E
118.2
N 20-55-58 E
119.22
#6 Set HUB
4764.47
4742.95
N 49-52-41 E
162.31
#5A FND CB CONTY BND
4666.35
4621.49
N 22-13-46 E
7.00
#5 Set HUB
4659.87
4618.84
N 60-26-08 W
130.07
95.44
79-47-52
#4 FND I.P.
4595.87
4731.97
S 75-20-03
299.93
N 13-46-24 E
390.28
346.02
N 7-49-33 E
102.79
5007.54
4646.46
101-25-50
4921.55
4654.03
96.36
4571.71
4639.64
330.63
S 39-46-0 W
N 10-51-13
450.03
4341.73
4520.48
237-15-40
4224.37
4706.23
200.00
N 49-41-25 E
4133.13
4521.36
~~4146.68~~
~~4532.68~~
50.01
49.95
N 90-18-23 W
4075.17
4604.50
4094.99
4553.72
4056.90
4586.03
99.97
25.98
FNC

130-39-55
59-55-23
70-44-32 W
101-25-50
172-10-22
7-49-33
56-28-20
64-17-58

123-31-41
56-28-20

390.28
346.02
44.27

17-29-40
37-37-35
55-07-15

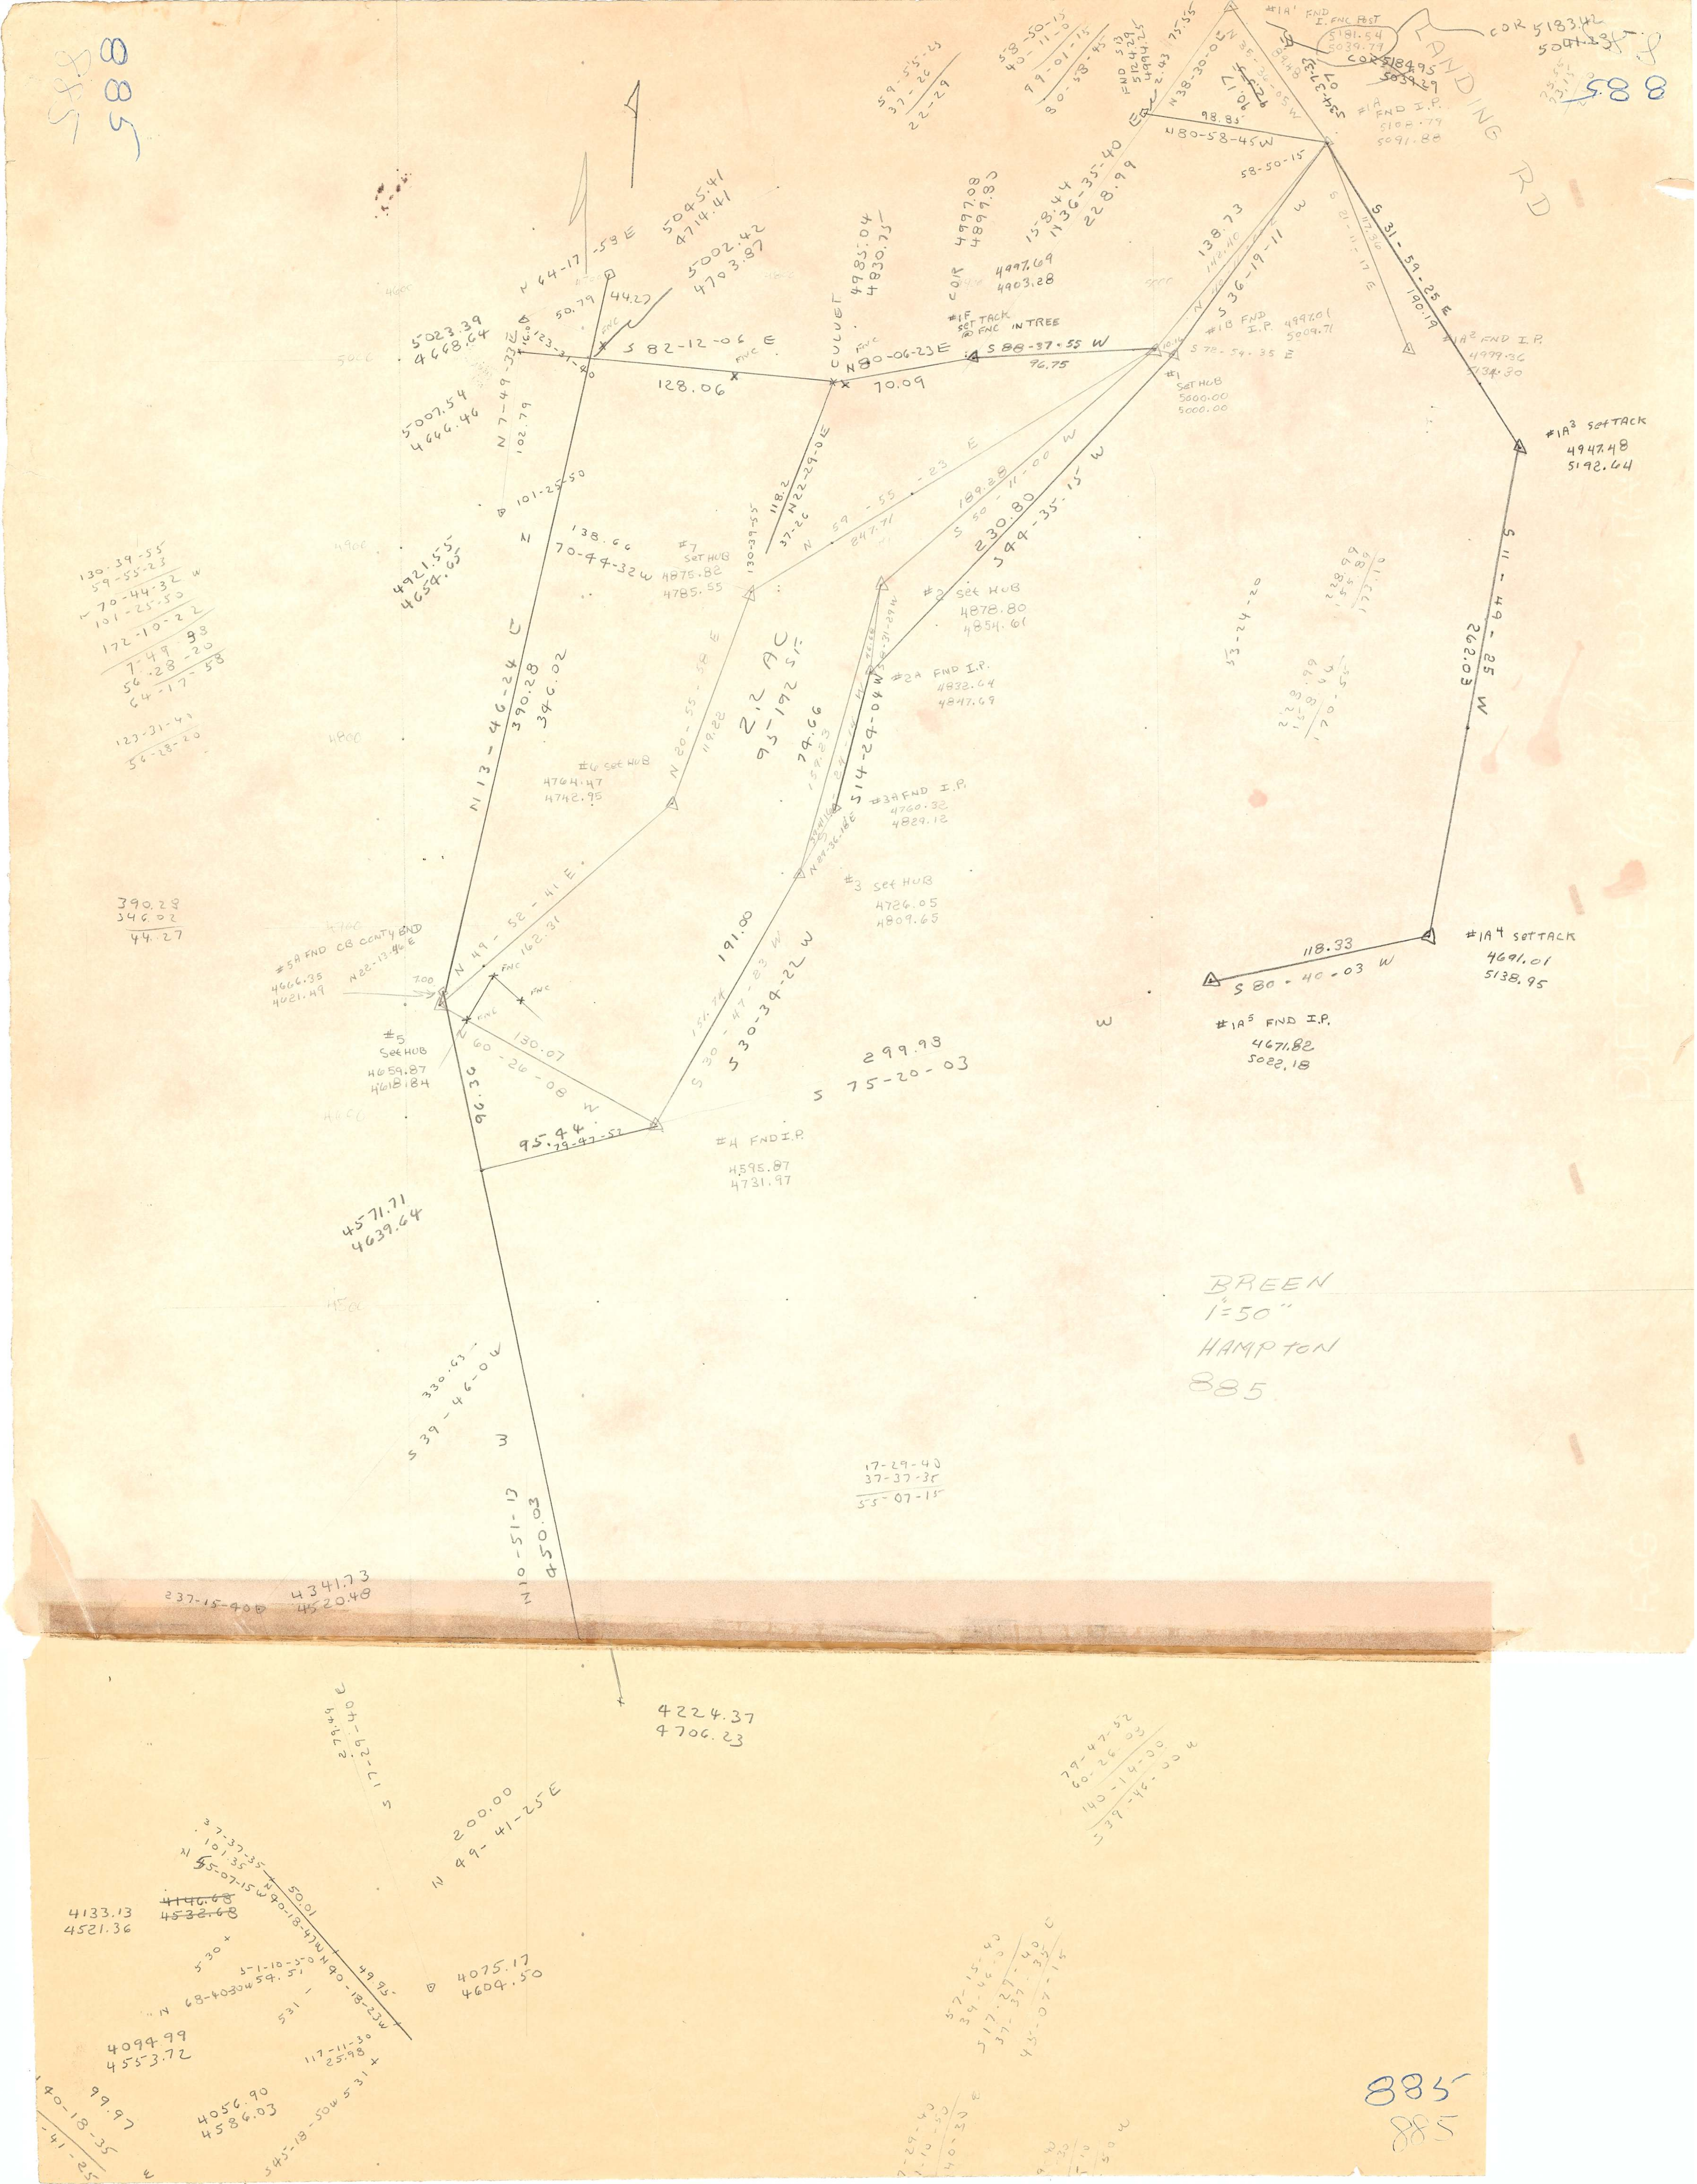BREEN
1"=50"
HAMPTON
885

885
885

588
885